


FILENAME=85X00101.DCN
SFEO FILE SFEO1.DCN (REV 0)

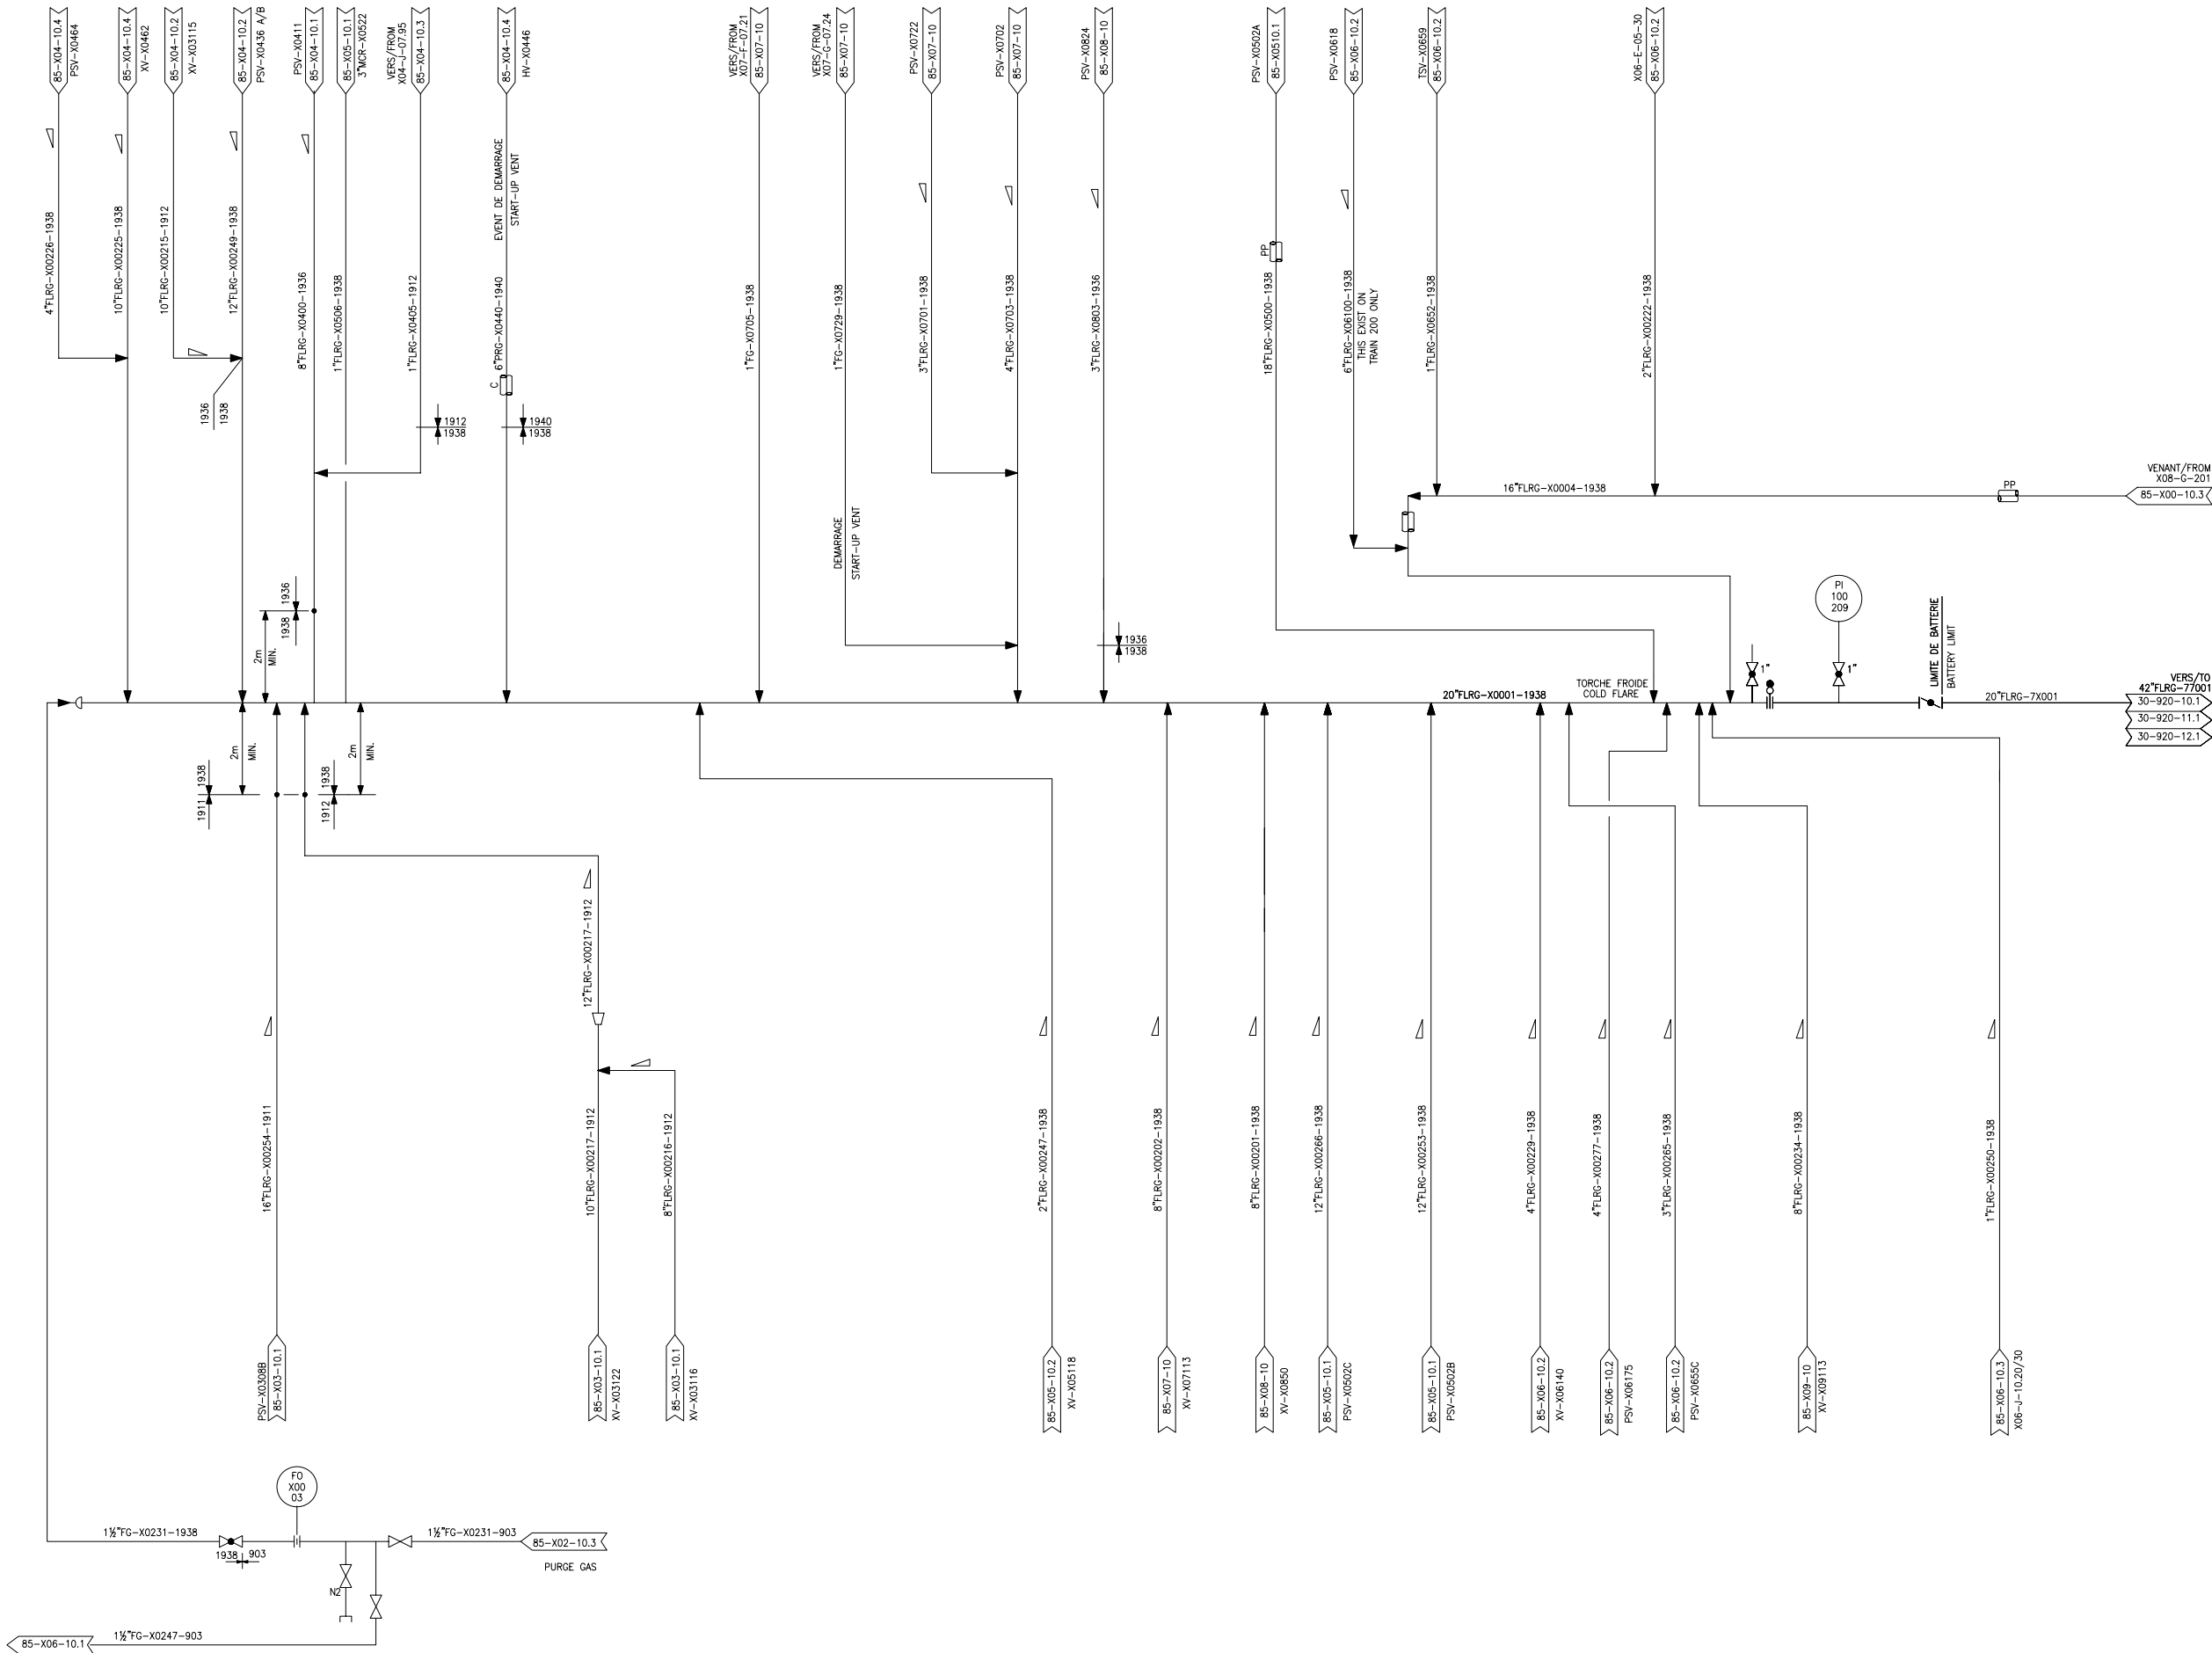

1. POUR LES SYMBOLES STANDARD DES EQUIPEMENTS, TUYAUTERIES ET INSTRUMENTS, SE REFERER AUX PLANS NO. 00-N-11/12
2. POUR LES DETAILS DE LA TUYAUTERIE DES TORCHES ET D'ELIMINATION DANS LA SECTION DE LIQUEFACTION VOIR LE P & ID 85-X00-10.3

1. FOR STANDARD SYMBOLS FOR EQUIPMENT, PIPING AND INSTRUMENTS REFER TO DWG's 00-N-11/12
2. FOR GENERAL ARRANGEMENT OF INSTRUMENT OF INSTRUMENTS AIR LINES REFER TO DWG. PS-85-X01-36.

CE PLAN EST LA COPIE D'UN DOCUMENT ORIGINAL FOURNI PAR SONATRACH.
SON CONTENU TECHNIQUE DEMEURE LA RESPONSABILITE DE SONATRACH,
A L'EXCEPTION DES INFORMATIONS COMPLEMENTAIRES ELABOREES PAR BECHTEL
POUR LE PROJET DE RENOVATION.

THIS DRAWING IS A COPY OF AN ORIGINAL SONATRACH SUPPLIED DOCUMENT.
THE TECHNICAL CONTENT REMAINS THE RESPONSIBILITY OF SONATRACH,
EXCEPT TO THE EXTENT THAT THE DRAWING INCORPORATES INFORMATION
DEVELOPED BY BECHTEL FOR THE RENOVATION PROJECT.

THIS PIPING AND INSTRUMENTATION DIAGRAM IS DERIVED FROM:
85-X00-10

REVIEW APPROVALS											
PIPING	INST	PROCESS	LOSS PREV	START —UP—	MECH	M & GS	CH.	SY. ENG.	ENG MGR	CUST	
11-01-2004	AS BUILT					B.B					
31-07-1995	REVISED AS NOTED					AC		GC			
16-06-1994	ISSUED — FINAL					KD	JCW	NPI	JCW		
08-02-1993	REISSUED FOR RECORD					KD	WM	NPI	JCW	CM	
12-07-1993	ISSUED FOR RECORD					ANC	JCW	NPI	GC	CM	
26-01-1993	ISSUED FOR RECORD					KD	WM	NPI	JCW	CM	
REV. DATE	REVISION					BY	CHK'D	OTO VDR	SENZ ENH	PROL ENH	CUST
SCALE	DETAIL DRAWN					VERIFIED CHECKED					
BECHTEL LIMITED LONDON											
SONATRACH UNITE GNL RENOVATION COMPLEXE GL1.2 BETHIOUA-ALGERIE						SONATRACH LNG PLANT GL1.2 RENOVATION BETHIOUA-ALGERIA					
SCHEMA DES TUYAUTERIES ET INSTRUMENTATION: PROCÉDE SYSTEME TORCHE ET ELIMINATION COLLECTEUR TORCHE FROID											
PROCESS : PIPING & INSTRUMENT DIAGRAM FLARE AND DISPOSAL SYSTEM COLD FLARE HEADER											
		JOB No.			DRAWING No.					REV.	
		20784			85-X00-10.1					5	

20	21
PLOT TIME:	\$\$\$\$SYTIME\$\$\$\$\$\$\$