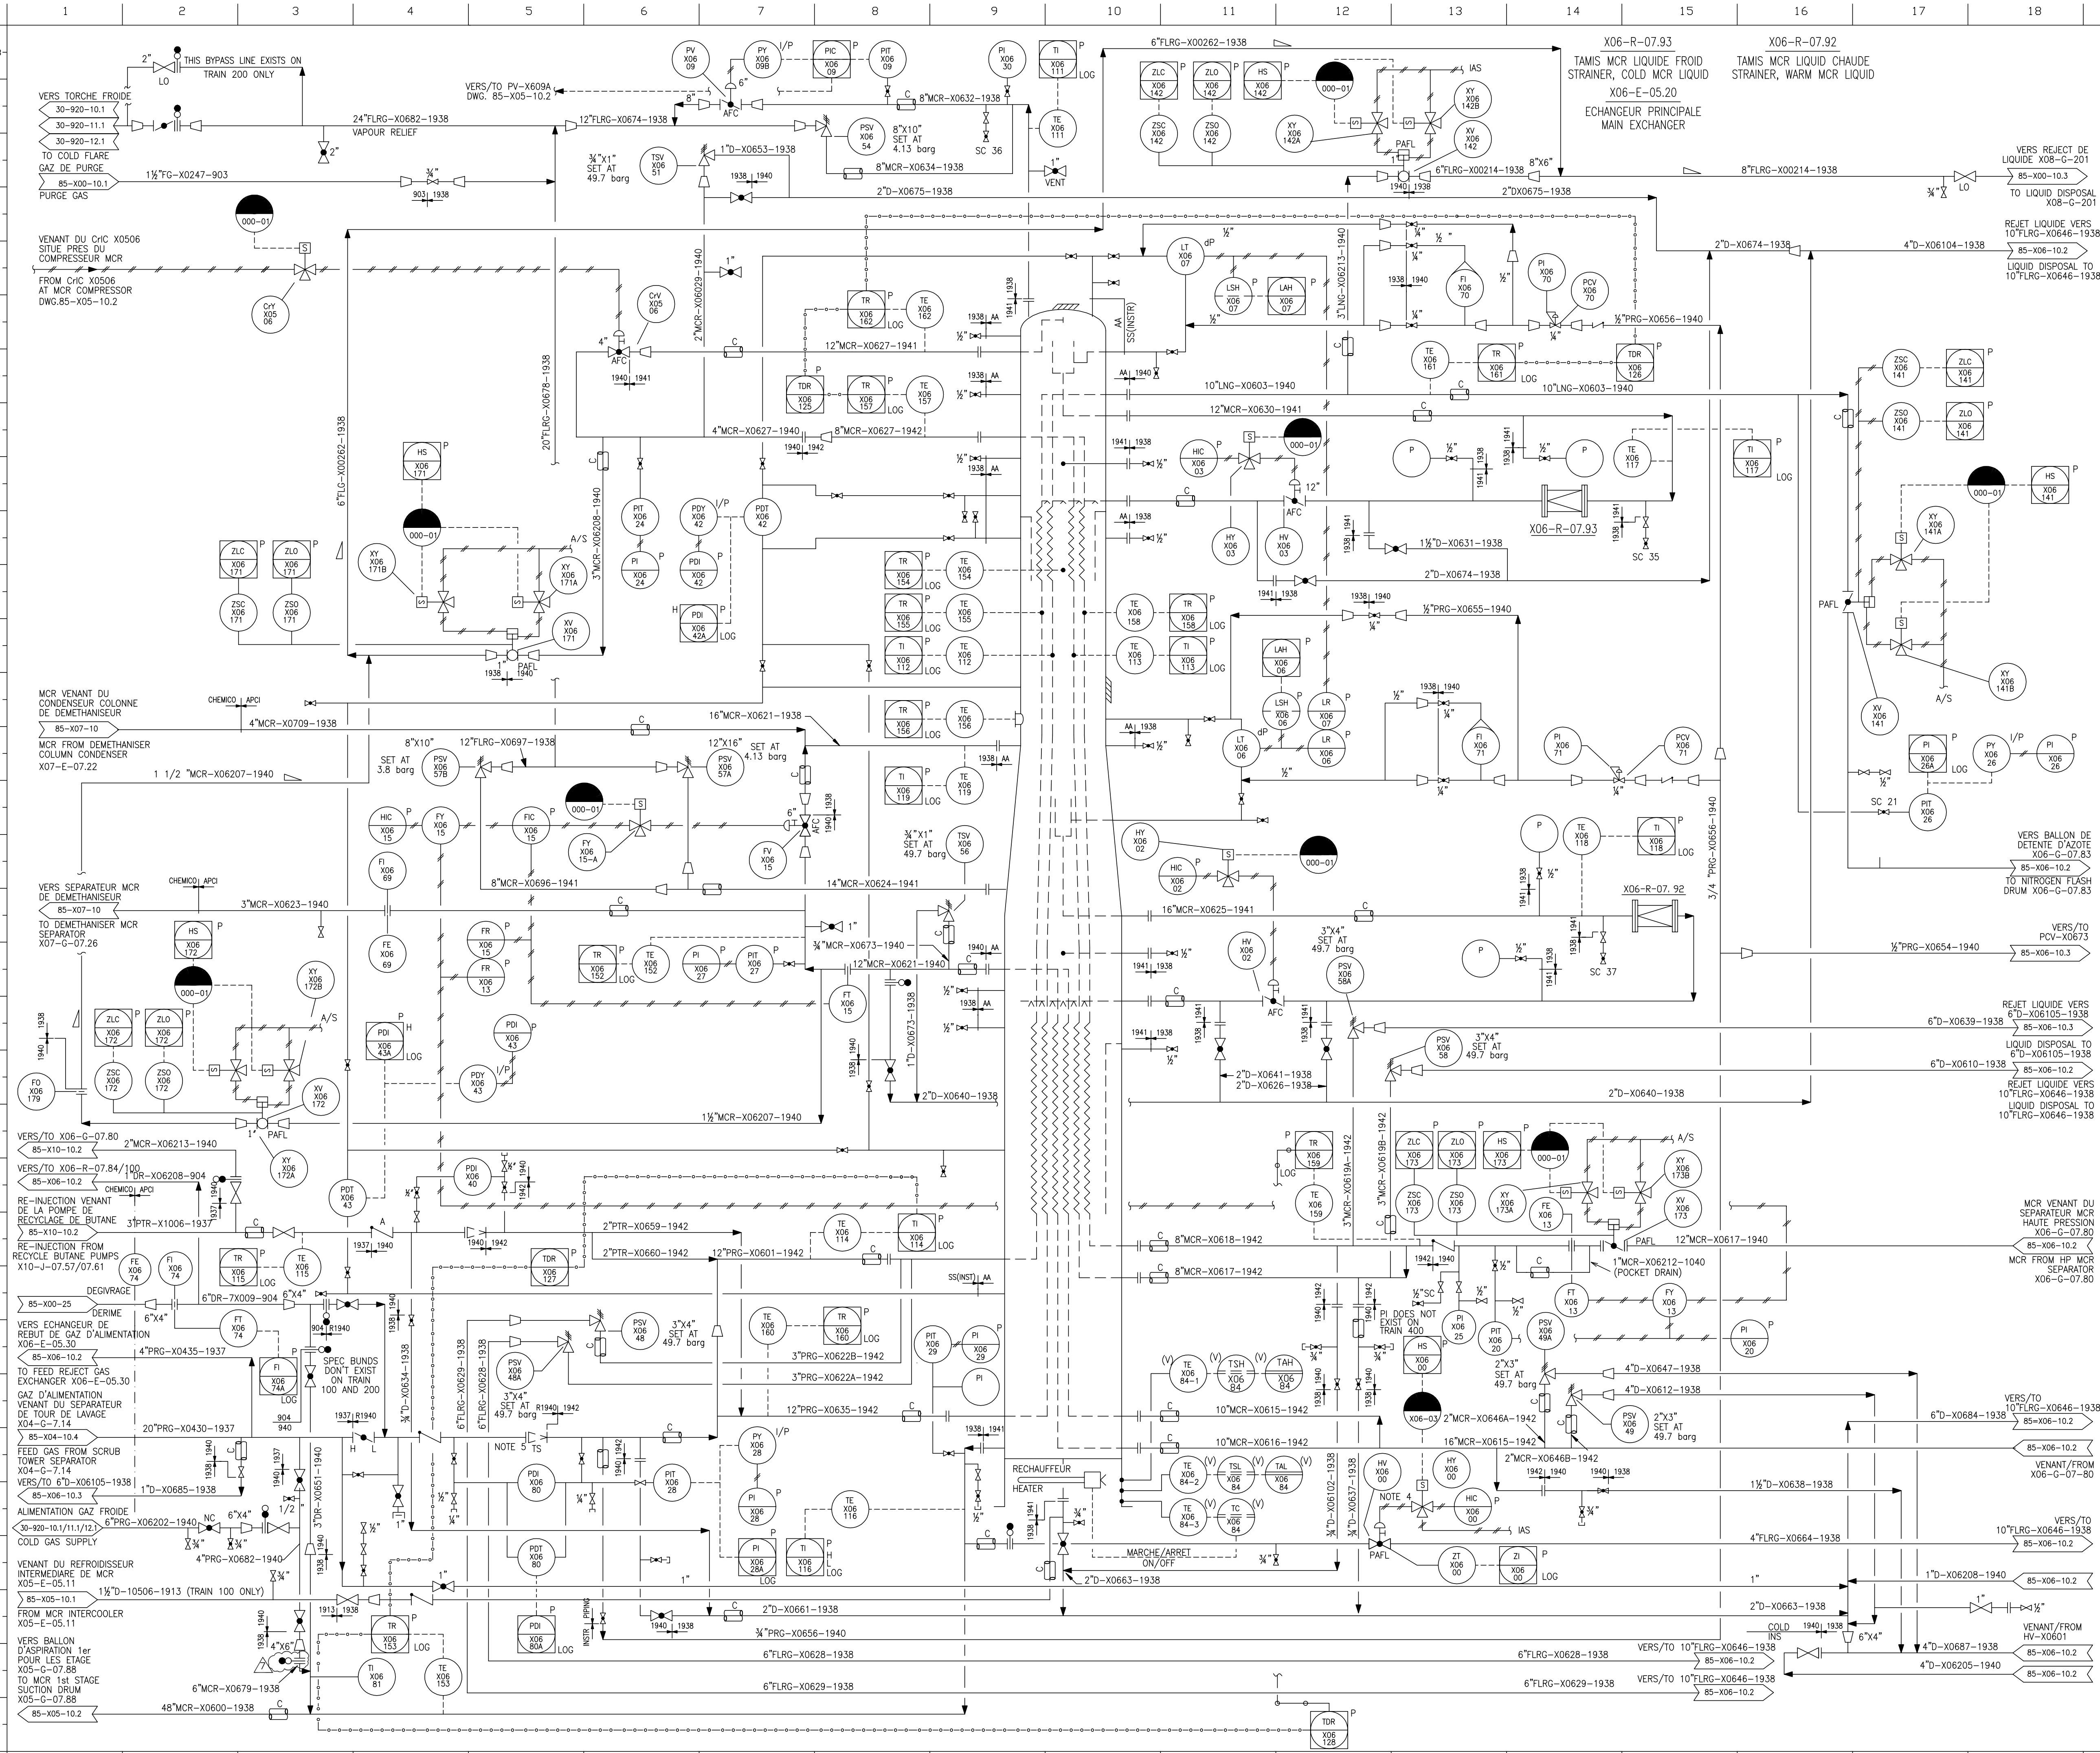


## REMARQUES

1. POUR LES SYMBOLES STANDARD DES EQUIPEMENTS, TUYAUTERIES ET INSTRUMENTS, SE REFERER AUX PLANS NO. 00-N-11/12.
2. SUPPRIME
3. TOUS LES CODES DE CLASSIFICATION DE TUYAUTERIE POUR LES NOUVELLES TUYAUTERIES FONT REFERENCE A LA SPECIFICATION 20784-L-001. LE PREFIX R'EST SOUS ENTENDU.
4. POUR ASSURER LA CONDITION DE "VERROUILLAGE EN CAS DE PANNE D'ALIMENTATION D'AIR/COURANT" (PAFL) LA VANNE HV-X0600 SERA EQUIPEE DE VANNES DE "VERROULLAGE.
4. LE JOINT DE TROUVENT EN AMONT DU FILTRE DOIT CORRESPONDRE A LA NOUVELLE SPECIFICATION (R1940).

## NOTES

1. FOR STANDARD SYMBOLS FOR EQUIPMENT, PIPING AND INSTRUMENTS REFER TO DWG's 00-N-11/12
2. DELETED.
3. ALL PIPING CLASS CODES FOR NEW PIPING REFER TO SPECIFICATION 20784-L-001 THE PREFIX IS IMPLIED.
4. TO ACHIEVE THE "PAFL" REQUIREMENT HV-X0600 WILL BE FITTED WITH "LOCK-UP" VALVES.

FOR DCS CONTROL ON TRAINS 500 &600 REFER TO P & IDS IN THE "85-500" SERIES .

CE DIAGRAMME REPRESENTE UNE DISPOSITION TYPE DES 6 TRAINS DE. PROCEDE. DES DIFFERENCES MINEURES EXISTANTE SUR CHAQUE TRAIN.

THIS DIAGRAM REPRESENTS A TYPICAL ARRANGEMENT FOR THE 6 PROCESS. TRAINS. MINOR DISSIMILARITIES EXIST ON EACH TRAIN.

CE PLAN EST LA COPIE D'UN DOCUMENT ORIGINAL FOURNI PAR SONATRACH. SON CONTENU TECHNIQUE DEMEURE LA RESPONSABILITE DE SONATRACH A L'EXCEPTION DES INFORMATIONS COMPLEMENTAIRES ELABOREES PAR BECHTEL POUR LE PROJET DE RENOVATION.

THIS DRAWING IS A COPY OF AN ORIGINAL SONATRACH SUPPLIED DOCUMENT. THE TECHNICAL CONTENT REMAINS THE RESPONSIBILITY OF SONATRACH, EXCEPT TO THE EXTENT THAT THE DRAWING INCORPORATES INFORMATION DEVELOPED BY BECHTEL FOR THE RENOVATION PROJECT.

CE SCHEMA DES TUYAUTERIES ET INSTRUMENTATION EST DERIVE DES PLANS:

THIS PIPING AND INSTRUMENTATION DIAGRAM IS DERIVED FROM:

1894-85-X06-10 REV. 22

## REVIEW APPROVALS

| PIPING | INST | PROCESS | LOSS PREV | START -UP | MECH | M & QS | CH. SYS. ENG | ENG MGR | CLIENT |
|---|---|---|---|---|---|---|---|---|---|
| | | | | | | | | | |

| REV. | DATE | REVISION | BY | CH'K | DFTG SUPV | DES'N ENG'R | PROJ. ENG'R | CLIENT |
|---|---|---|---|---|---|---|---|---|
| 7 | 20-06 2006 | AJOUT D'UN PLAN DE BRIDE AU NIVEAU DE LA LIGNE 6"MCR-X0676 PAR JOB# T-1087 | B.B | B.B | | | | |
| 6 | 27-07 2004 | AS-BUILT | BB | | | | | |
| 5 | 28-06 2004 | CHANGEMENT DE SPECIFICATION 1940 à R1940 | B.B | A.B | | | | |
| 4 | 31-05 1995 | REVISED AS NOTED | | | | GC | | |
| 3 | 16-05 1994 | ISSUED - FINAL | KD | JCW | NPI | JCW | | |
| 2 | 08-02 1993 | REISSUED FOR RECORD | DC | WIM | NPI | JCW | CM | |
| 1 | 12-07 1993 | ISSUED FOR RECORD | AG | GC | NP | JW | CM | |
| 0 | 29-01 1993 | ISSUED FOR DESIGN | NPI | NAS | NAS | | | |

ECHELLE SCALE NONE | ETABLI DRAWN N. IRVING | VERIFIE CHECKED M. A. SADIQ

# BECHTEL LIMITED
LONDON

SONATRACH UNITE GNL
RENOVATION COMPLEXE GL1.Z
BETHIOUA,ALGERIE

SONATRACH LNG PLANT
GL1.Z RENOVATION
BETHIOUA,ALGERIA

SCHEMA DES TUYAUTERIES ET INSTRUMENTATION :PROCEDE
UNITE DE LIQUEFACTION 200
ECHANGEUR PRINCIPAL-FEUILLE 1

PIPING & INSTRUMENT DIAGRAM : PROCESS
LIQUEFACTION
MAIN EXCHANGER-SHEET 1

| JOB No. | DRAWING No. | REV. |
|---|---|---|
| 20784 | 85-X06-10.1 | 7 |

PLOT TIME: $$$$SYTIME$$$$$$